

11-DEC-2012 13:54

Chad. Havens


TIME\$\$\$ 006043ER18-0
8825Full.pen

R:\07400004\006043\DGW\As Bullets\DGW\006043ER18-0.dgn


STATE GA PROJECT NUMBER CSNHS-0006-001043

SHEET NO. 581 TOTAL SHEETS 668


AS-BUILT PLANS 12/12/12

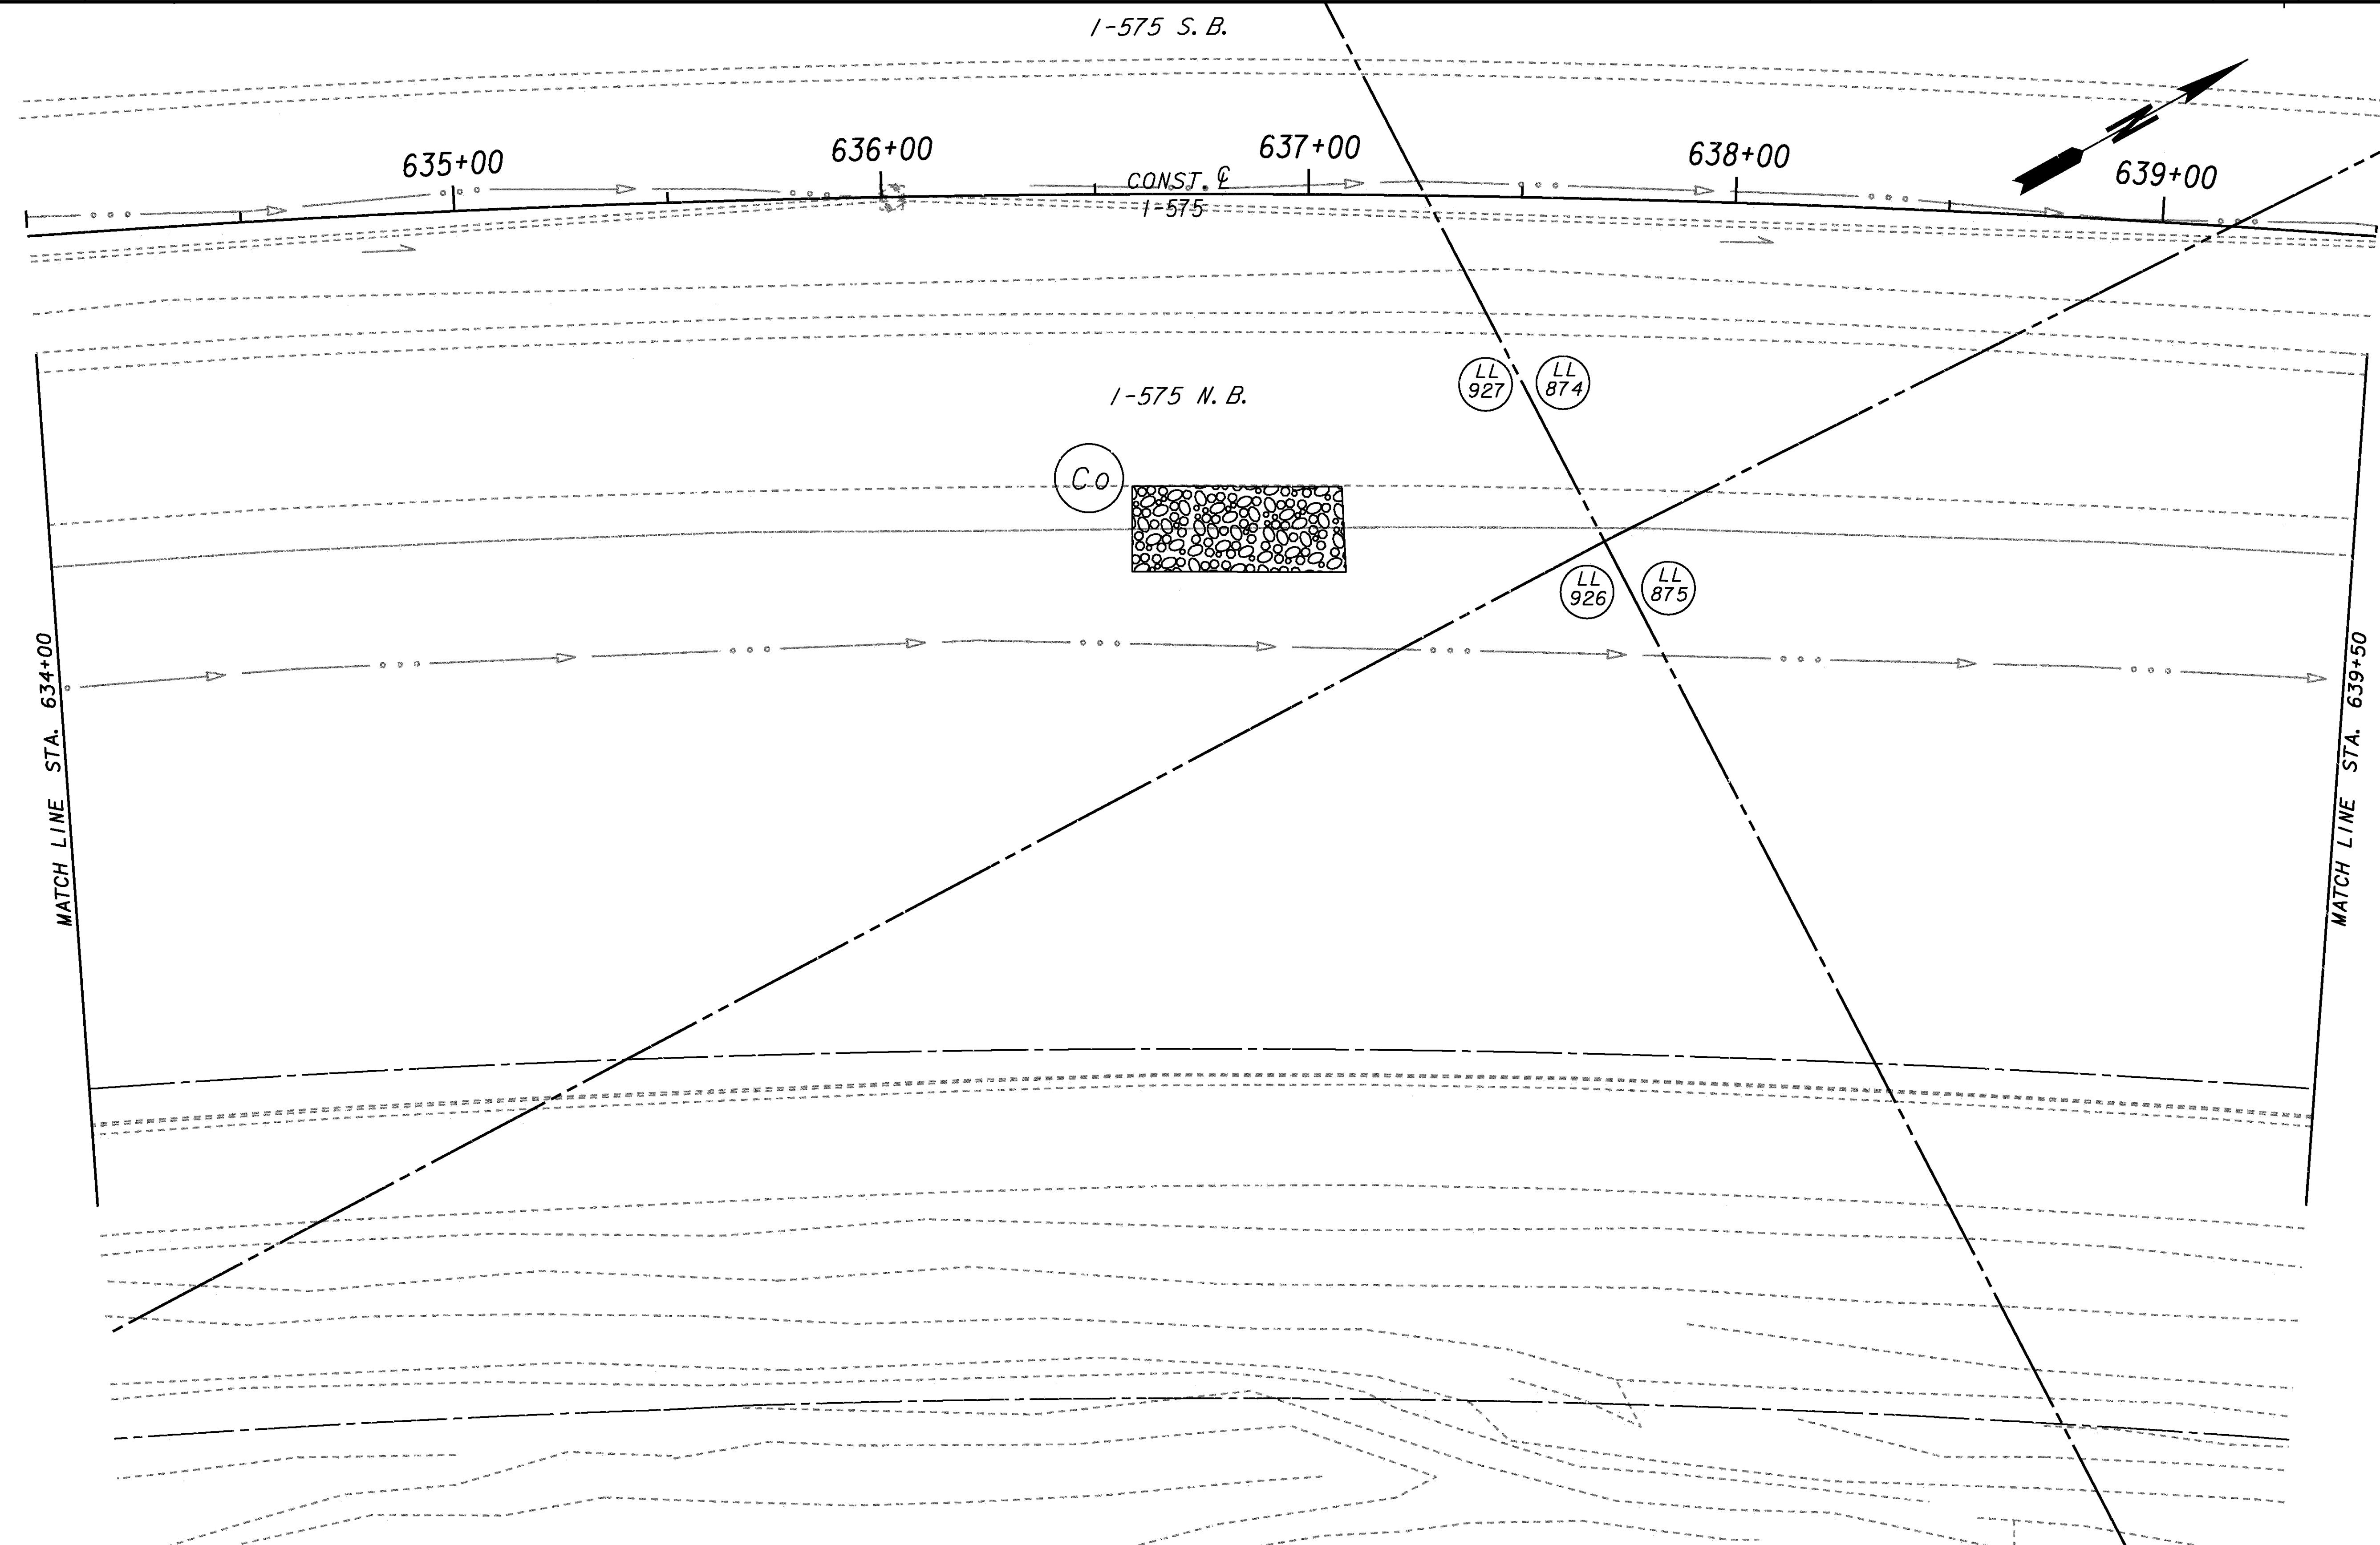

LEGEND	
PAVEMENT REMOVAL	
TEMPORARY CONSTRUCTION PAVEMENT	
PERMANENT CONSTRUCTION	
CONCRETE MEDIAN CONSTRUCTION	
MILL & OVERLAY CONSTRUCTION	
OPEN LANES OF TRAFFIC	

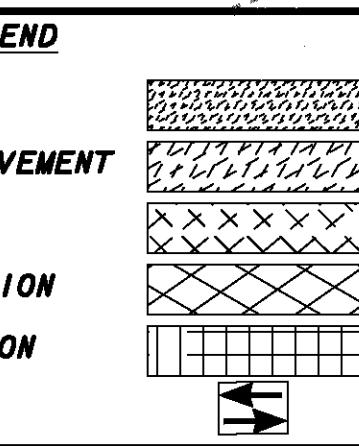

THE LPA GROUP **LPA**
TRANSPORTATION CONSULTANTS
3595 ENGINEERING DRIVE
NORCROSS, GEORGIA 30092
(770) 263-9118

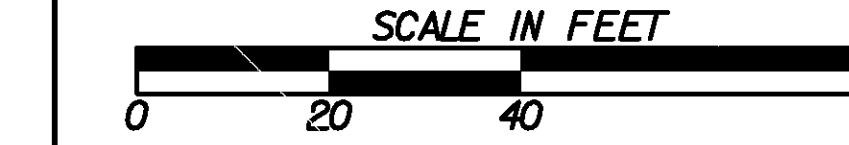

REVISION DATES		

STATE OF GEORGIA
DEPARTMENT OF TRANSPORTATION
OFFICE: INNOVATIVE PROGRAM DELIVERY
BMP LOCATION DETAILS
INITIAL PH.
I-575 NB AUXILIARY LANE
BEGIN CONSTR. TO STA. 639+50

DRAWING NO. 54-018